





PREPARED BY:
AR. SHELTON O. GANUAP
ARCHITECT
PITE NO.
401-833-3300
TIN. NO.
401-833-3300
SHEET NO. 04
DATE: AUGUST 2022
SCALE: AS SHOWN
AS-BUILT PLAN
BASEMENT FLOOR PLAN (MUSEUM & LIBRARY)
ARCHITECTURAL-
BASEMENT FLOOR PLAN (PUMP & MECHANICAL ROOM)

PROJECT TITLE:
AS - BUILT PLAN OF THE SSS MAIN BUILDING
LOCATION:
SSS Main Building, East Avenue, Diliman, Quezon City

OWNER:
SOCIAL SECURITY SYSTEM
East Avenue, Diliman, Quezon City

DRAWN BY:
ARCHITECTONE GROUP
DATE:
AUGUST 2022
SCALE: AS SHOWN
AS-BUILT PLAN
BASEMENT FLOOR PLAN (PUMP & MECHANICAL ROOM)
ARCHITECTURAL-
BASEMENT FLOOR PLAN (MUSEUM & LIBRARY)
SHEET NO. 04
A

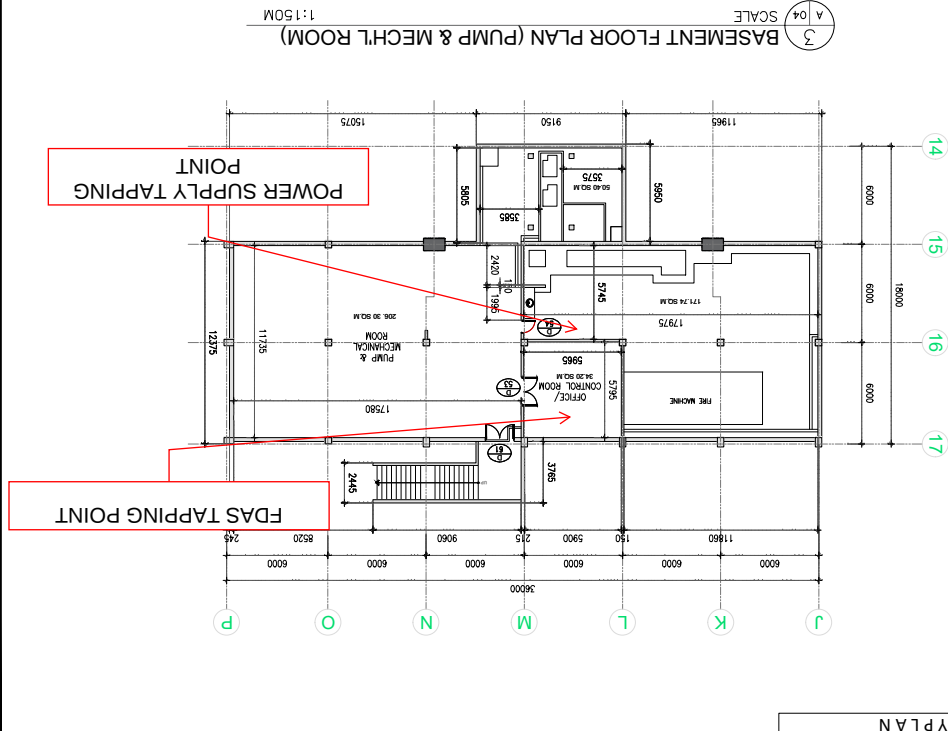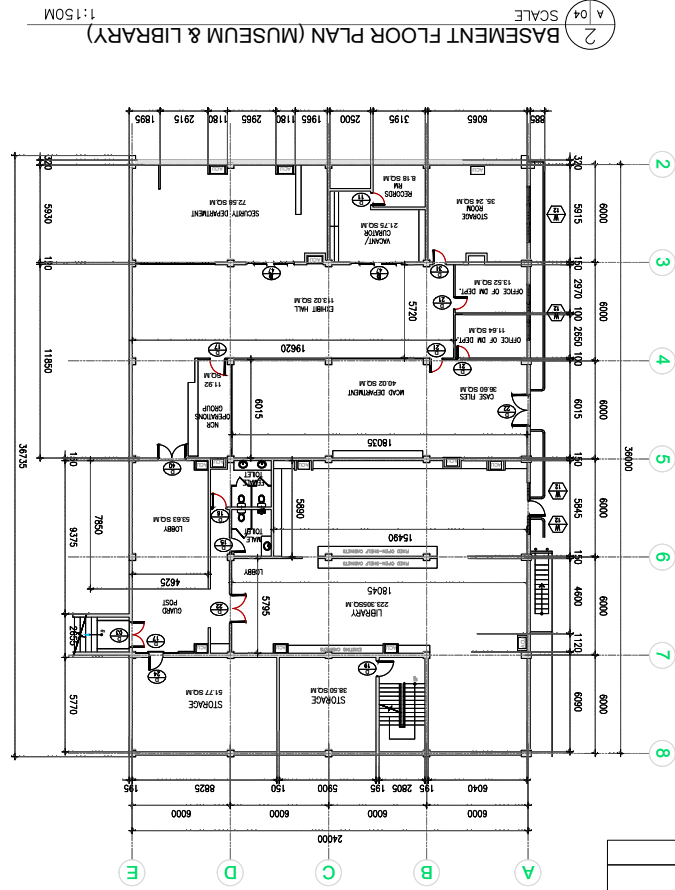

POWER SUPPLY TAPPING POINT

FDAS TAPPING POINT